

	1		T	r	·
PHASE 2	G	G	DW	DW	
2 CHANGE	Y	Y	DW	DW	
PHASE 4	R	R	W	W	
4 PED. CLEAR	R	R	FL DW	FL DW	H
4 CHANGE	R	R	DW	DW	
PRE-EMPTION A	G	G	DW	DW	
A CHANGE	Y	Y	DW	DW	<b></b>
FLASHING OPERATION	FL Y	FL Y	DARK	DARK	-

SIGNALS		SIGNS		
1,2	3,4	5		
(R) (Y) (G) 12"	12"			
> - OPTICAL PRE- DETECTOR EY		W11-2A 36" × 36"		

J.S. 40 EAST (WEST WASHINGTON STREET) IS

ASSUMED TO RÙN IN AN EAST-WEST DIRECTION

## CONSTRUCTION DETAILS

NSTALL 27' STEEL POLE, 32' MAST ARM, SIGNAL HEADS, SIGNS, 10' STREET LIGHTING ARM AND 250 WATT H.P.S. (CUTOFF) LUMINAIRE WITH PHOTOELECTRIC CELL, OPTICOM DETECTOR, PEDESTRIAN SIGNALS, PUSHBUTTON AND SIGN (NOTE: 1-2", 90-DEGREE P.V.C. BEND).

NSTALL 10 STEEL PEDESTAL POLE, PEDESTRIAN SIGNAL, PUSHBUTTON AND SIGNAL (NOTE: 1-2" 90 DEGREE P.V.C. BEND)

REMOVE EXISTING PEDESTAL POLE, PEDESTRIAN SIGNAL, PUSHBUTTON AND

NSTALL BASE-MOUNTED CABINET, SIZE #5, AND CONTROLLER WITH ALL NECESSARY EQUIPMENT AS SHOWN (NOTE: 2-4", 90-DEGREE P.V.C. BENDS; AND 2-2", 90-DEGREE P.V.C. BENDS).

) INSTALL HANDHOLE.

 $\rangle$  INSTALL 2" P.V.C. (SCHEDULE 40) ELECTRICAL CONDUIT (TRENCHED).

angle INSTALL 2" P.V.C. (SCHEDULE 80) ELECTRICAL CONDUIT (SLOTTED).

angle USE EXISTING HANDHOLE.

angle INSTALL 4" P.V.C. (SCHEDULE 80) ELECTRICAL CONDUIT (SLOTTED).

> REMOVE AND REPLACE EXISTING BRICK SIDEWALK.

> REMOVE AND REPLACE EXISTING CONCRETE SIDEWALK.

REMOVE EXISTING CROSSWALK LINES.

) INSTALL 10' OF 2" P.V.C. (SCHEDULE 80) ELECTRICAL CONDUIT — RISER ON SIDE OF BUILDING ADJACENT TO EXISTING RISÉR, COIL 25' OF ADDITIONAL CABLE.

INSTALL 12" SOLID WHITE LINE FOR CROSSWALKS.

angle remove existing stop bar.


angle INSTALL 24" SOLID WHITE LINE.

REMOVE EXISTING CONTROLLER, CABINET, STEEL POLE, MAST ARM, SIGNALS, LUMINAIRE, LIGHTING ARM AND FOUNDATION.

CONSTRUCT SIDEWALK RAMP

UTILITY LEGEND CABLE TELEVISION ELECTRIC CABLES --- T ---- TELEPHONE CABLES ---- A ----- AERIAL CABLES


## NEMA PHASING

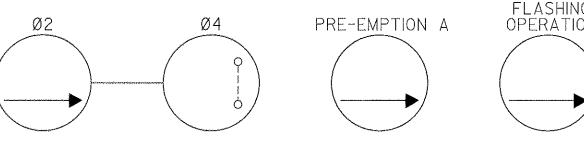


PHASING NOTES:

I.PHASES ASSOCIATED BY A SOLID LINE WILL NOT OPERATE CONCURRENTLY

2. PHASES ASSOCIATED BY A DASHED LINE WILL OPERATE CONCURRENTLY

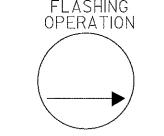

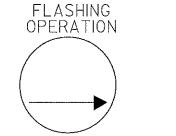

SPECIFICATION QUANTITY UNIT SECTION ĒΑ

A. EQUIPMENT TO BE SUPPLIED BY THE SHA.

DESCRIPTION BASE MOUNTED LOCAL CABINET (SIZE 5) LESS DETECTION EQUIPMENT WITH

EQUIPMENT LISTS

8 PHASE ASC II CONTROLLER WITH TELEMETRY AND OPTICOM PRE-EMPTION MODULE FLAT SHEET ALUMINUM SIGNS CONSISTING OF: - 1 EACH W11-2a (36" X 36")-MAST ARM MOUNT

MD. |STPG-218-1(7)E| 31 B. EQUIPMENT TO BE FURNISHED AND/OR INSTALLED BY THE CONTRACTOR. QUANTITY UNIT SECTION DESCRIPTION 205 TEST PIT EXCAVATION REMOVAL OF EXISTING SIDEWALK CY 206 12 INCH WHITE PERMANENT PREFORMED PAVEMENT MARKING TAPE 24 INCH WHITE PERMANENT PREFORMED

325

ANY WIDTH

BASE MOUNT

INSTALL OVERHEAD SIGN

FURNISH AND INSTALL

FURNISH AND INSTALL

PAINTED BLACK

MODEL 521

813

805

EΑ

EΑ

150

225

FHWA

REGION NO

SHEET TOTAL

PROJ. NO

PAVEMENT MARKING TAPE

REMOVE EXISTING PAVEMENT MARKINGS-

INSTALL CONTROLLER AND CABINET-

12 INCH 1 WAY 3 SECTION (R, Y, G) SIGNAL HEAD HAVING PROPER ADJUSTABLE MAST ARM BRACKET, AND TUNNEL VISORS-PAINTED BLACK

12 INCH 1 WAY 2 SECTION PEDESTRIAN SIGNAL HEAD-PEDESTAL TOP MOUNT-

FURNISH AND INSTALL OPTICOM DETECTOR EYE-

FURNISH AND INSTALL ELECTRICAL HANDHOLE FURNISH AND INSTALL CONCRETE FOR SIGNAL

FURNISH AND INSTALL 2" SCHEDULE 40

FURNISH AND INSTALL 4" SCHEDULE 40

FURNISH AND INSTALL 2" SCHEDULE 80

FURNISH AND INSTALL CONTROL AND

FURNISH AND INSTALL PUSHBUTTON

CUT, CLEAN AND CAP TRAFFIC SIGNAL

FURNISH AND INSTALL 250 WATT HIGH PRESSURE SODIUM LAMP AND LUMINAIRE

FURNISH AND INSTALL 10 FOOT LIGHTING ARM ON SIGNAL STRUCTURE-PAINTED GREEN FURNISH AND INSTALL GROUND ROD-3/4 INCH DIAMETER X 10-FOOT LENGTH

AS-BUILT FOR TRAFFIC SIGNAL

FURNISH AND INSTALL NO. 6 AWG

STRANDED BARE COPPER GROUND WIRE

FURNISH AND INSTALL ELECTRICAL CABLE-

FURNISH AND INSTALL 27-FOOT STEEL POLE WITH A SINGLE 38-FOOT MAST ARM-

RIGID PVC CONDUIT-TRENCHED

RIGID PVC CONDUIT-TRENCHED

RIGID PVC CONDUIT-SLOTTED

DISTRIBUTION EQUIPMENT

PAINTED GREEN

WITH PHOTOCELL

STRUCTURE

REMOVE AND REPLACE EXISTING BRICK SIDEWALK

4 INCH CONCRETE SIDEWALK

SHEETS

(CL SERVICE ATTACHED # 48 **U.S. 40 EAST** (W. Washington St.) -R/W LINE WIRING DIAGRAM

## H,J,M,N,P,I/C M,N,P,PS-WIRING LEGEND E,F,H,J ~G,I/C A - 5 CONDUCTOR CABLE (NO. 14 A.W.G.) B - 5 CONDUCTOR CABLE (NO. 14 A.W.G.) C - 3 CONDUCTOR CABLE (NO. 14 A.W.G.) - 3 CONDUCTOR CABLE (NO. 14 A.W.G.) - 2 CONDUCTOR CABLE (NO. 14 A.W.G.) 2 CONDUCTOR CABLE (NO. 14 A.W.G. - 3M OPTICOM DETECTOR CABLE, MODEL 138 - 2 CONDUCTOR TRAY CABLE (NO. 12 A.W.G.) ·STRANDED BARE COPPER GRÒUND WIRE (NÓ. 6 A.W.G.) - STRANDED BARE COPPER GROUND WIRE (NO. 6 A.W.G.) - STRANDED BARE COPPER GROUND WIRE (NO. 6 A.W.G.) M - 1 CONDUCTOR CABLE (NO. 4 A.W.G.) N - 1 CONDUCTOR CABLE (NO. 4 A.W.G.) P - 1 CONDUCTOR CABLE (NO. 4 A.W.G.) + - 3/4"x10' GROUND ROD PS - PROPOSED ELECTRICAL SERVICE I/C - INTERCONNECT CABLE

1 CONDUCTOR (NO. 4 AWG - THHN/THWN) 150 FURNISH AND INSTALL ELECTRICAL CABLE-2 CONDUCTOR (NO 14 AWG) 810 FURNISH AND INSTALL ELECTRICAL CABLE-175 3 CONDUCTOR (NO 14 AWG) FURNISH AND INSTALL ELECTRICAL CABLE-175 5 CONDUCTOR (NO 14 AWG) FURNISH AND INSTALL 2-CONDUCTOR 150 TRAY CABLE (NO 12 AWG) FURNISH AND INSTALL 10-FOOT BREAKAWAY PEDESTAL POLE-PAINTED GREEN 150 FURNISH AND INSTALL OPTICOM M-138 DETECTOR CABLE ĒΑ REMOVE AND DISPOSE OF EXISTING FOUNDATION 12" BELOW GRADE DELIVERY OF SALVAGED EQUIPMENT REMOVE AND DISPOSE OF EXISTING EQUIPMENT REMOVAL OF EXISTING SIGNAL EQUIPMENT TO LS BE SALVAGED NOTE: ALL EQUIPMENT AND/OR MATERIALS TO BE REMOVED BY THE CONTRACTOR, BUT NOT LISTED BELOW, SHALL BECOME THE PROPERTY OF THE CONTRACTOR. QUANTITY UNIT DESCRIPTION

## INTERSECTION DESCRIPTION

PROP. POWER

TO BUILDING)

G° Wal-. "

SZW

THIS INTERSECTION IS U.S. 40 EAST (WEST WASHINGTON STREET) AND THE PEDESTRIAN CROSSING AT HAY'S ALLEY, CONSTRUCTION AT THIS INTERSECTION INVOLVES THE RECONSTRUCTION OF THE EXISITNG TRAFFIC SIGNAL AND INTERCONNECTION WITH THE OTHER SIGNALIZED INTERSECTION IN THE NEW CITY-WIDE SYSTEM. IT IS ASSUMED THAT U.S. 40 EAST (WEST WASHINGTON STREET) RUNS IN A EAST-WEST DIRECTION.

II. INTERSECTION OPERATION

I. GENERAL

THE INTERSECTION WILL OPERATE IN A NEMA TWO (2) PHASE PEDESTRIAN ACTUATED MODE. WESTBOUND WASHINGTON STREET AND THE PEDESTRIAN CROSSING WILL OPERATE IN SEPERATE PHASES. THE PEDESTRIAN SIGNALS WILL OPERATE UPON PEDESTRIAN ACTUATION. PRE-EMPTION ON EASTBOUND U.S. 40 EAST (WEST WASHINGTON STREET) WILL CAL PRE-EMPTION A. A NEW EIGHT PHASE FULLY ACTUATED CONTROLLER WITH TELEMETRY MODULE, AND PRE-EMPTION HOUSED IN A GROUND MOUNTED CABINET WILL BE INSTALLED.

> A/E GROUP, INC. ENGINEERS • PLANNERS 181 E. Main Street Westminster, Maryland 21158 A/E Job No. 95-289

APPROVALS CHIEF, SIGNAL DESIGN SECTION DRAWN BY: <u>M. GE</u>SELL ASST. DISTRICT ENGINEER, TRAFFIC

CHIEF, TRAFFIC ENGINEERING DESIGN DIVISION

DIRECTOR, OFFICE OF TRAFFIC & SAFETY

REVISIONS

NOTE: EXISTING RIGHT-OF-WAY BASED ON INFORMATION PROVIDED BY THE CITY OF HAGERSTOWN MDOT - STATE HIGHWAY ADMINISTRATION

1 EA

Office of Traffic & Safety TRAFFIC ENGINEERING DESIGN DIVISION

LOG MI, 21E04036.02

US 40 East (West Washington St.) at Hay's Alley / Market Place

COUNTY: WASHINGTON .NO. SHEET NO.

3691

\_\_\_31\_\_oF \_\_\_66

CONTROLLER AND CABINET

PEDESTAL POLE AND BASE

STPG-218-1(7)E 05/30/97 1" = 20'WA95**35185** SCALE: . S.H.A. NO.

J. LAWRENCE

CHK. BY: